LEVEL 1 (GROUND) - MARKED-UP PLAN

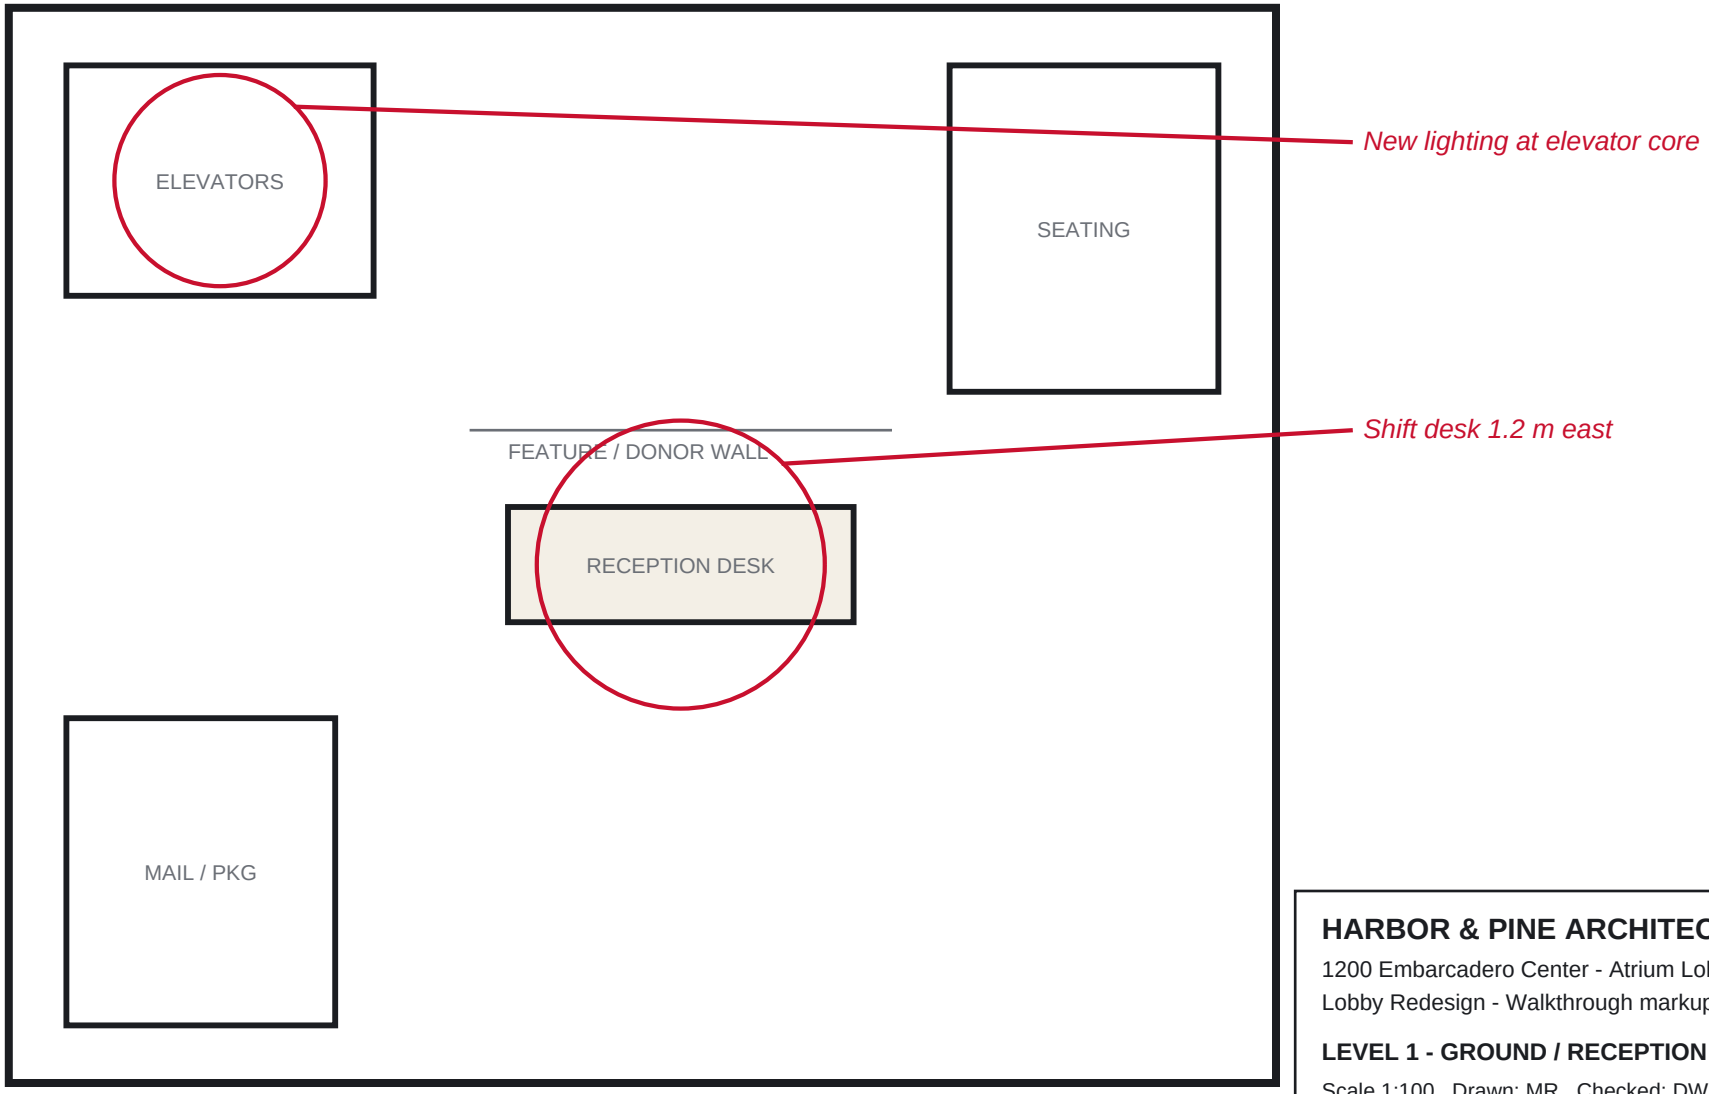

HARBOR & PINE ARCHITECTS

1200 Embarcadero Center - Atrium Lobby

Lobby Redesign - Walkthrough markups

LEVEL 1 - GROUND / RECEPTION

Scale 1:100 Drawn: MR Checked: DW

A-101

LEVEL 2 (MEZZANINE) - MARKED-UP PLAN

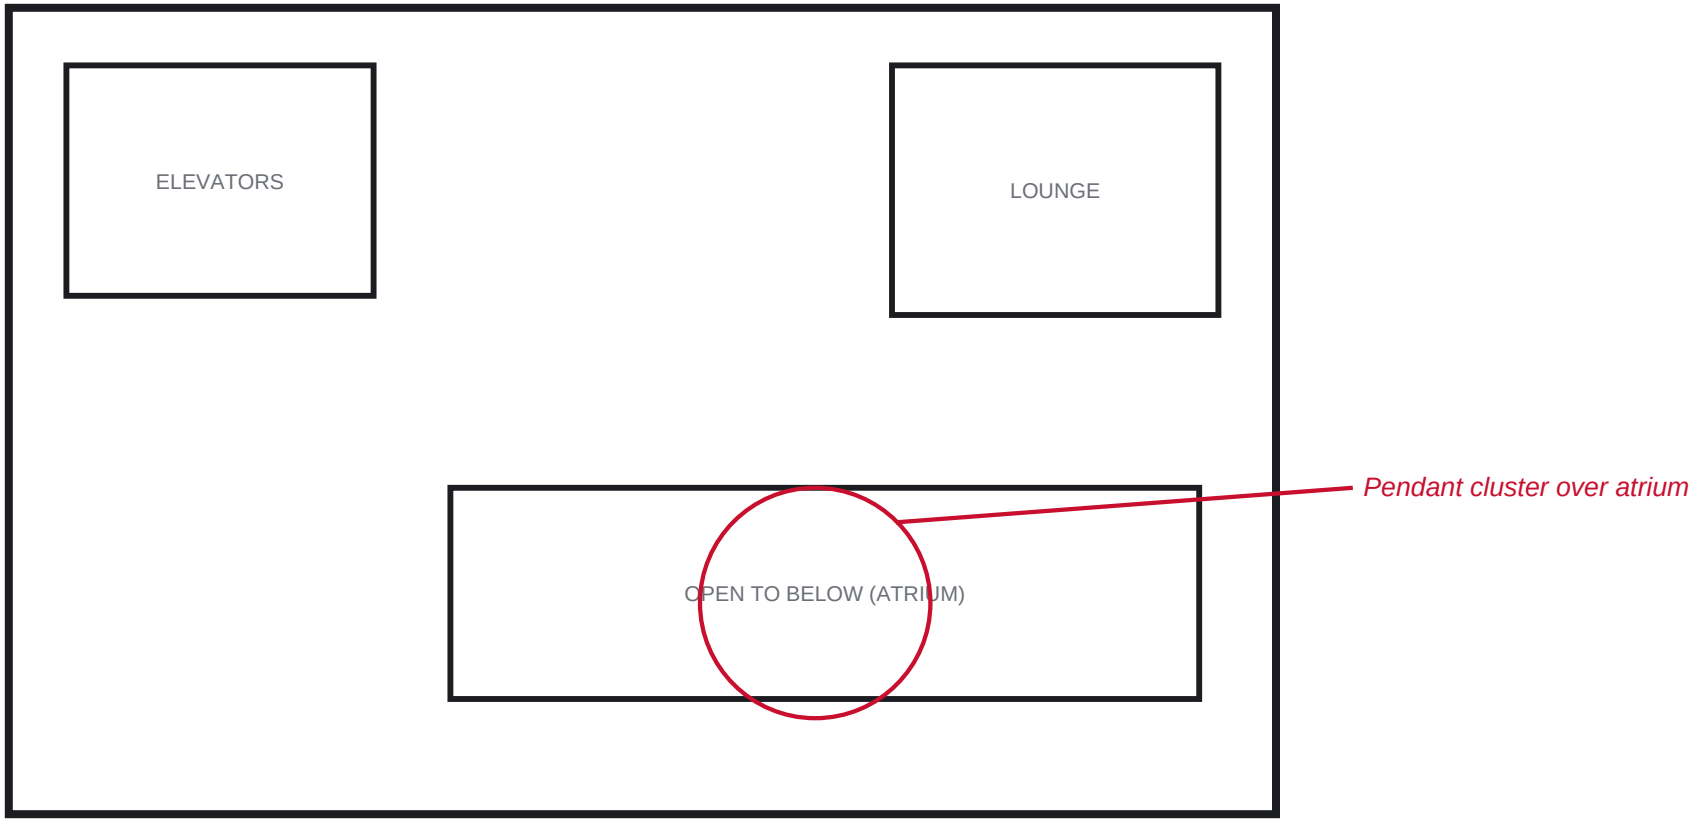

SCOPE OF WORK

Lobby redesign covers 2 levels: Level 1 (Ground) and Level 2 (Mezzanine).

Level 3 (tenant floor) is NOT IN SCOPE. Lighting and signage by landlord.

Per walkthrough markups, DW / MR.

HARBOR & PINE ARCHITECTS

1200 Embarcadero Center - Atrium Lobby

Lobby Redesign - Walkthrough markups

LEVEL 2 - MEZZANINE

Scale 1:100 Drawn: MR Checked: DW

A-102